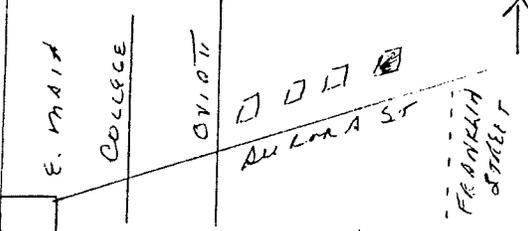


OHIO HISTORIC INVENTORY

Ohio Historic Preservation Office
Ohio Historical Center
Columbus, Ohio 43211

1. No.		4. Present Name(s) Residence, June Mohler	
2. County Summit		5. Other Name(s)	
3. Location of Negatives L. n of Negatives H. 50-4			
6. Specific Location 145 Aurora Street		16. Thematic Category C	
7. City or Town If Rural, Township & Vicinity Hudson		17. Date(s) or Period 1826	
8. Site Plan with North Arrow 		18. Style or Design Federal	
9. Coordinates Lat. _____ Long. _____ U.T.M. Reference 7 463655 45615839		19. Architect or Engineer	
10. Name Easting Northing Site <input type="checkbox"/> Structure <input type="checkbox"/> Building <input checked="" type="checkbox"/> Object <input type="checkbox"/>		20. Contractor or Builder	
11. Original Use? Yes <input type="checkbox"/> No <input checked="" type="checkbox"/>		21. Original Use, if apparent residence	
12. Is It Eligible? Yes <input checked="" type="checkbox"/> No <input type="checkbox"/>		22. Present Use residence	
13. Part of Estab. Yes <input checked="" type="checkbox"/> No <input type="checkbox"/> Hist. Dist.? No <input type="checkbox"/>		23. Ownership Public <input type="checkbox"/> Private <input checked="" type="checkbox"/>	
14. District Potent'l? Yes <input type="checkbox"/> No <input type="checkbox"/>		24. Owner's Name & Address, if known June Mohler 145 Aurora Street Hudson, 44236	
15. Name of Established District Hudson Local Ordinance		25. Open to Public? Yes <input type="checkbox"/> No <input checked="" type="checkbox"/>	
16. Further Description of Important Features Federal styling evident in the roof pitch, delicate frieze, corner boards and attic fanlight. Boxed cornice, single pane double hound windows in front gable (replacement); portico over front entrance, glazed top entry door. Former triple window (two 4-pane windows joining full windows) on front facade changed to remove small windows. Interior greatly changed in the early 1900's to Arts and Crafts influence. Two-story west wing on structural tile foundation. Evidence of early log cabin found in dining room.		26. Local Contact Person or Organization Hudson Heritage Association	
17. History and Significance recent repair work on dining room.		27. Other Surveys in Which Included	
18. Description of Environment and Outbuildings Home of the Reverend William Hanford, first permanent minister of the Congregational Church and first Secretary of the Board of Trustees of Western Reserve College; later owned by the first pastor of the Western Reserve College Church, the Reverend Beriah Green, who, between 1830 and 1833, used that pulpit to preach abolitionist sermons, later became nationally prominent for his anti-slavery writings. Emily Metcalf, who conducted a school for young ladies, lived here from 1887 until 1915. Note the stylistic resemblance to 129 Aurora Street, which the Reverend Hanford built for his sister. Mary Raymond. Residential street of historic houses, with heavy traffic.		28. No. of Stories 2	
19. Sources of Information Summit County Tax Assessment records Hudson Library and Historical Society, archives Personal inspection		29. Basement? Yes <input checked="" type="checkbox"/> No <input type="checkbox"/>	
		30. Foundation Material sandstone, cement plaster	
		31. Wall Construction wood frame	
		32. Roof Type & Material gable, asphalt shingle	
		33. No. of Bays Front 3 Side 2	
		34. Wall Treatment clapboard	
		35. Plan Shape upright/wing	
		36. Changes (Explain in #42) Addition <input checked="" type="checkbox"/> Altered <input checked="" type="checkbox"/> Moved <input type="checkbox"/>	
		37. Condition Interior good Exterior good	
		38. Preservation Underway? Yes <input checked="" type="checkbox"/> No <input type="checkbox"/>	
		39. Endangered? By What? Yes <input type="checkbox"/> No <input checked="" type="checkbox"/>	
		40. Visible from Public Road? Yes <input checked="" type="checkbox"/> No <input type="checkbox"/>	
		41. Distance from and Frontage on Road 95' 87'	
		Photo	
		46. Prepared by I. Newkirk, F. Barlow	
		47. Organization HHA	
		48. Date	
		49. Revision Date(s) 5/88	

Summit
Residence, June Mohler
Other Name(s)

Beckwith Residence Addition

As-Builts with Proposed Railing

PREPARED BY: DAVID FIKE

DATE PREPARED: _____


THESE DRAWINGS ARE THE PROPERTY OF PAUL FIKE BUILDERS. NO PERSONS SHALL BE ALLOWED TO ALTER, ERASE, COPY OR USE THESE DRAWINGS EXCEPT WITH WRITTEN PERMISSION OF PAUL FIKE BUILDERS. ALTHOUGH EVERY ATTEMPT HAS BEEN MADE FOR ACCURACY OF THESE DRAWINGS, THE BUILDER OR DRAFTER CANNOT BE RESPONSIBLE FOR DIMENSIONS OF FIELD CONDITIONS. BUILDER RESERVES THE RIGHT TO ADJUST ANY DIMENSION PLUS OR MINUS ACCORDINGLY.

THE BUILDER MUST VERIFY ALL THE DESIGN SPECIFICATIONS SHOWN ON THESE DRAWINGS PER THE CONTRACT WITH THE OWNER.


DRAFTER ASSUMES NO RESPONSIBILITY FOR DESIGN LOADS, ETC.

BUILDER ASSUMES ALL RESPONSIBILITY FOR SIZES OF L.V.L.S, STEEL BEAMS, FLOOR JOISTS, ROOF RAFTERS, CEILING JOISTS, ETC.


THESE PLANS GENERALLY MEET FEDERAL STANDARDS AND CODE REQUIREMENTS. DRAFTER DOES NOT GUARANTEE INDIVIDUAL OR LOCAL INTERPRETATIONS OF SUCH REQUIREMENT. THE BUILDER IS SOLELY RESPONSIBLE FOR ANY MODIFICATIONS OR CHANGES NECESSARY TO MEET SUCH INTERPRETATIONS. THESE DRAWINGS DO NOT PROVIDE SPECIFIC DETAIL IN AREAS INCLUDING BUT NOT LIMITED TO NAILING, CAULKING, FLASHING, PAINTING AND WATERPROOFING. BUILDER RESPONSIBLE TO PROVIDE PROPER SUPERVISED WORKMANSHIP.

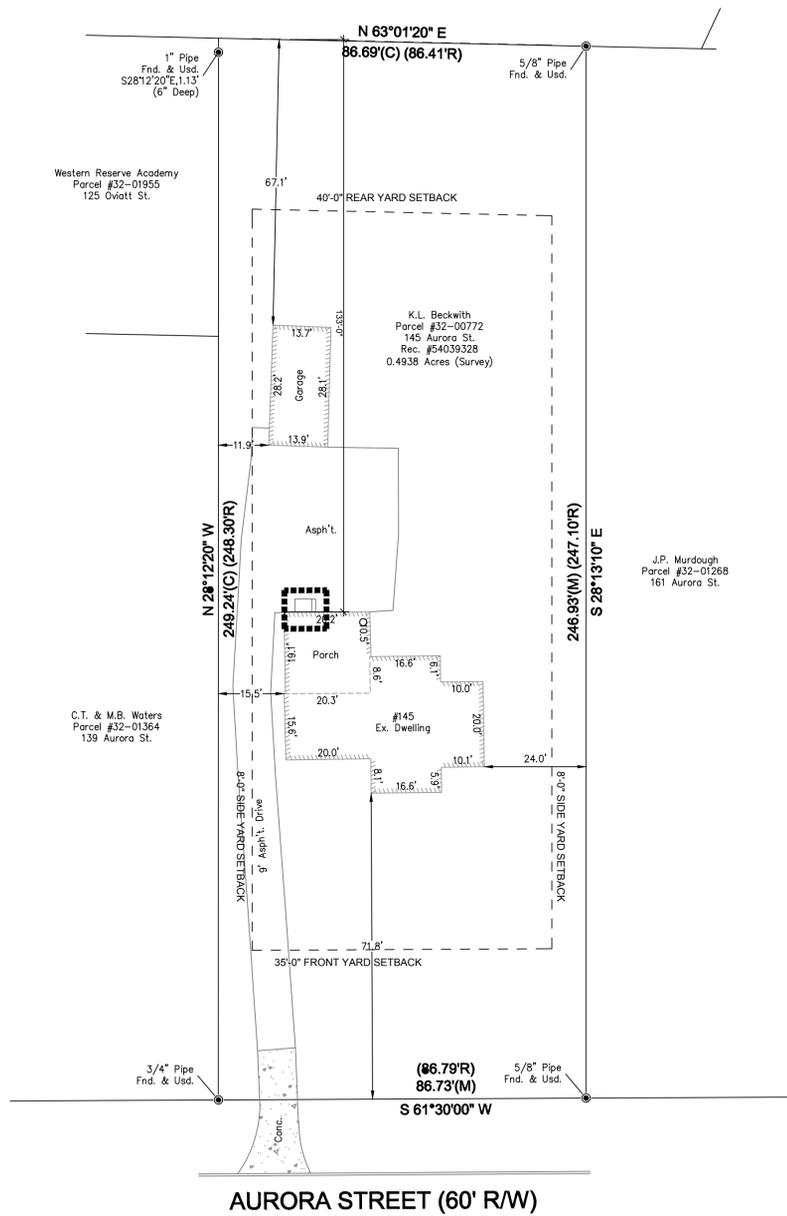


2 Site Plan
Scale: 1" = 20'-0"

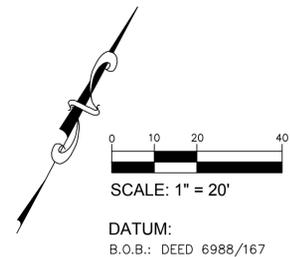

- LEGEND**
- 1000 --- Ex. Contour
 - 999 --- PR. CONTOUR
 - --- Ex. Tree Line
 - --- PR. CLEARING
 - X --- PR. SILT FENCE
 - PR. GRADE Ex. Grade PR. DRAINAGE
 - X --- TREE TO BE REMOVED
 - CE --- PR. CONST. ENTRANCE
- Ex. = Existing PR. = PROPOSED
- SA ST --- Ex. San/Stm. MH.
 - TBL --- Ex. Pedestals
 - Hydrant --- Ex. Hydrant
 - --- Iron Pin Fnd./Set
 - --- Iron Pipe Fnd.
 - --- Mon. Fnd.

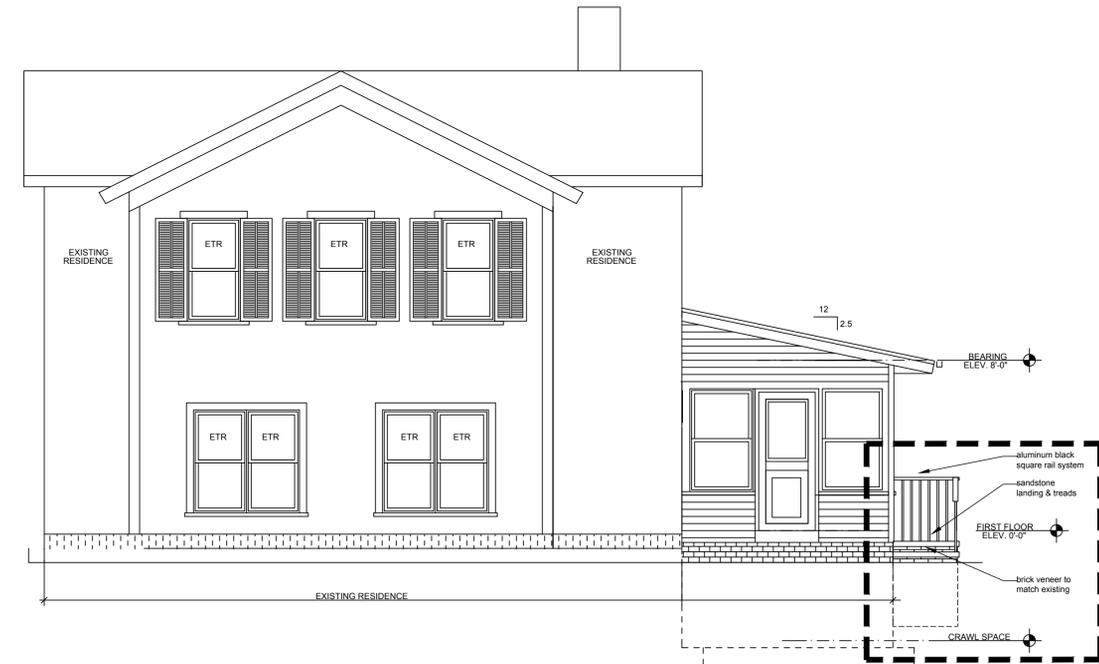

3 Right Elevation
Scale: 1/4" = 1'-0"

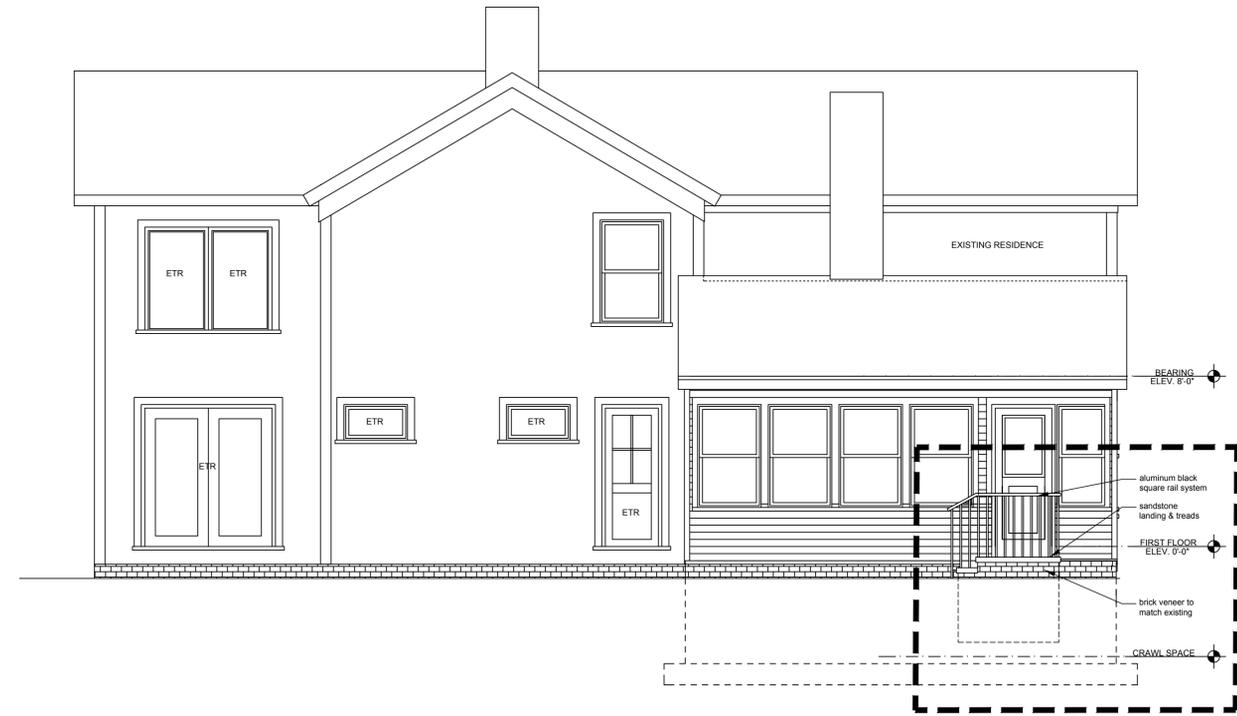

1 Right Elevation
Scale: 1/4" = 1'-0"

Date	Issue
4/26/2021	Revision

Project Address:
Beckwith Residence
145 Aurora Street
Hudson, Ohio 44236




Project Address
 Beckwith Residence
 145 Aurora Street
 Hudson, Ohio 44236


Sheet Number
A1

WEST ELEVATION

Previously Approved: 8/8/2018

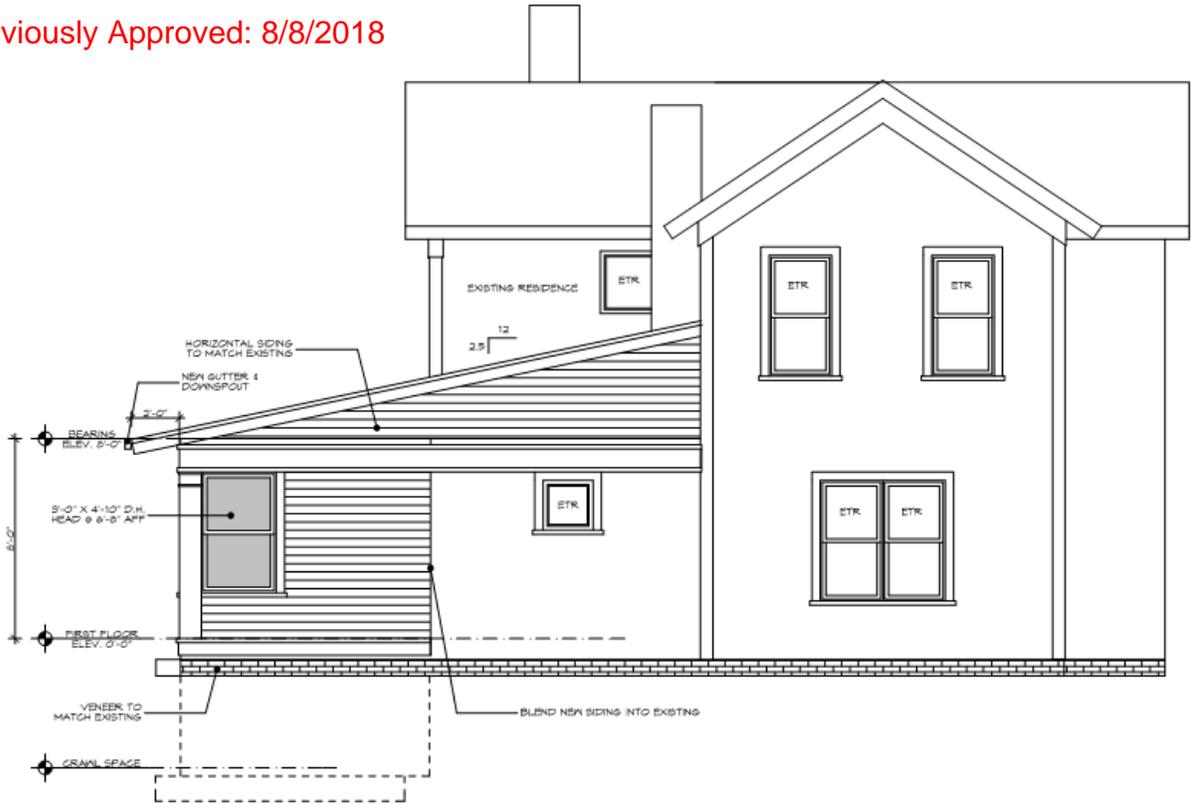


As-Built

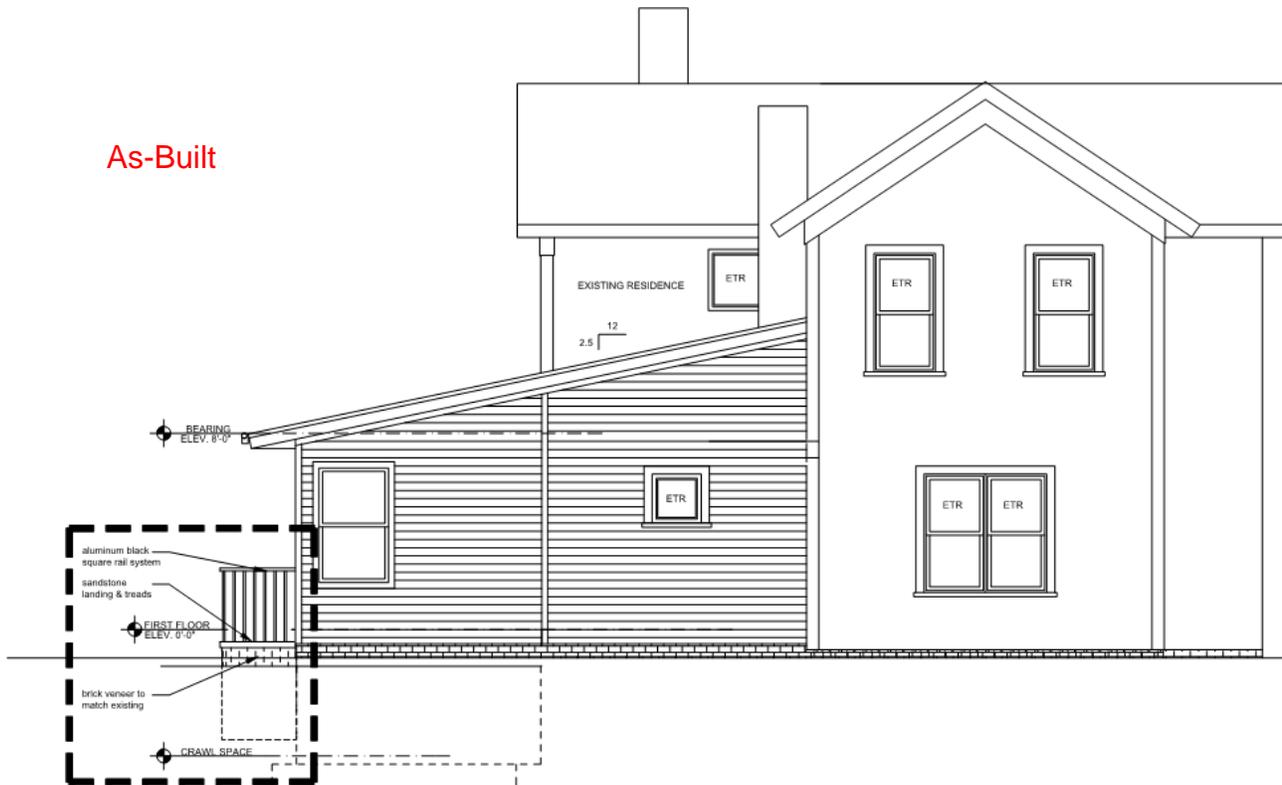


NORTH ELEVATION

Previously Approved: 8/8/2018

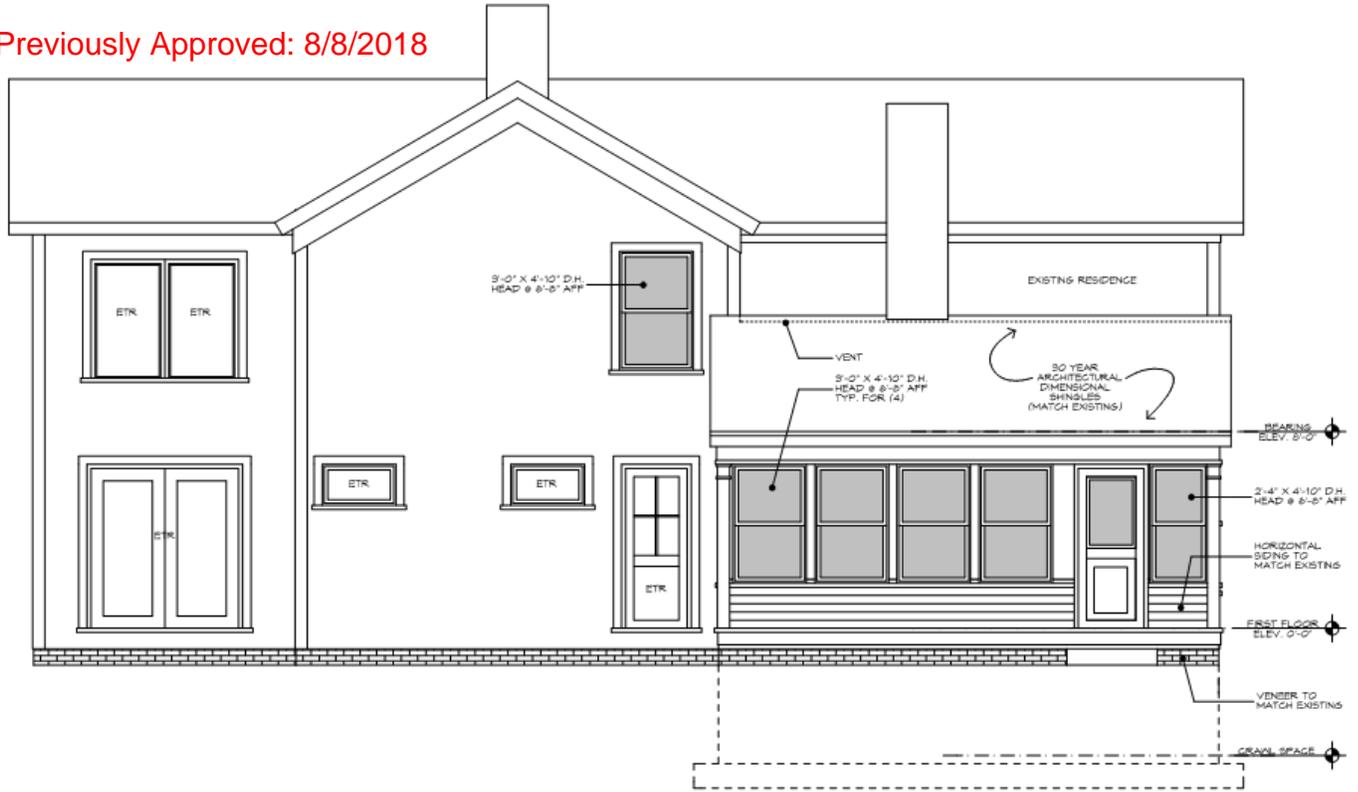


As-Built

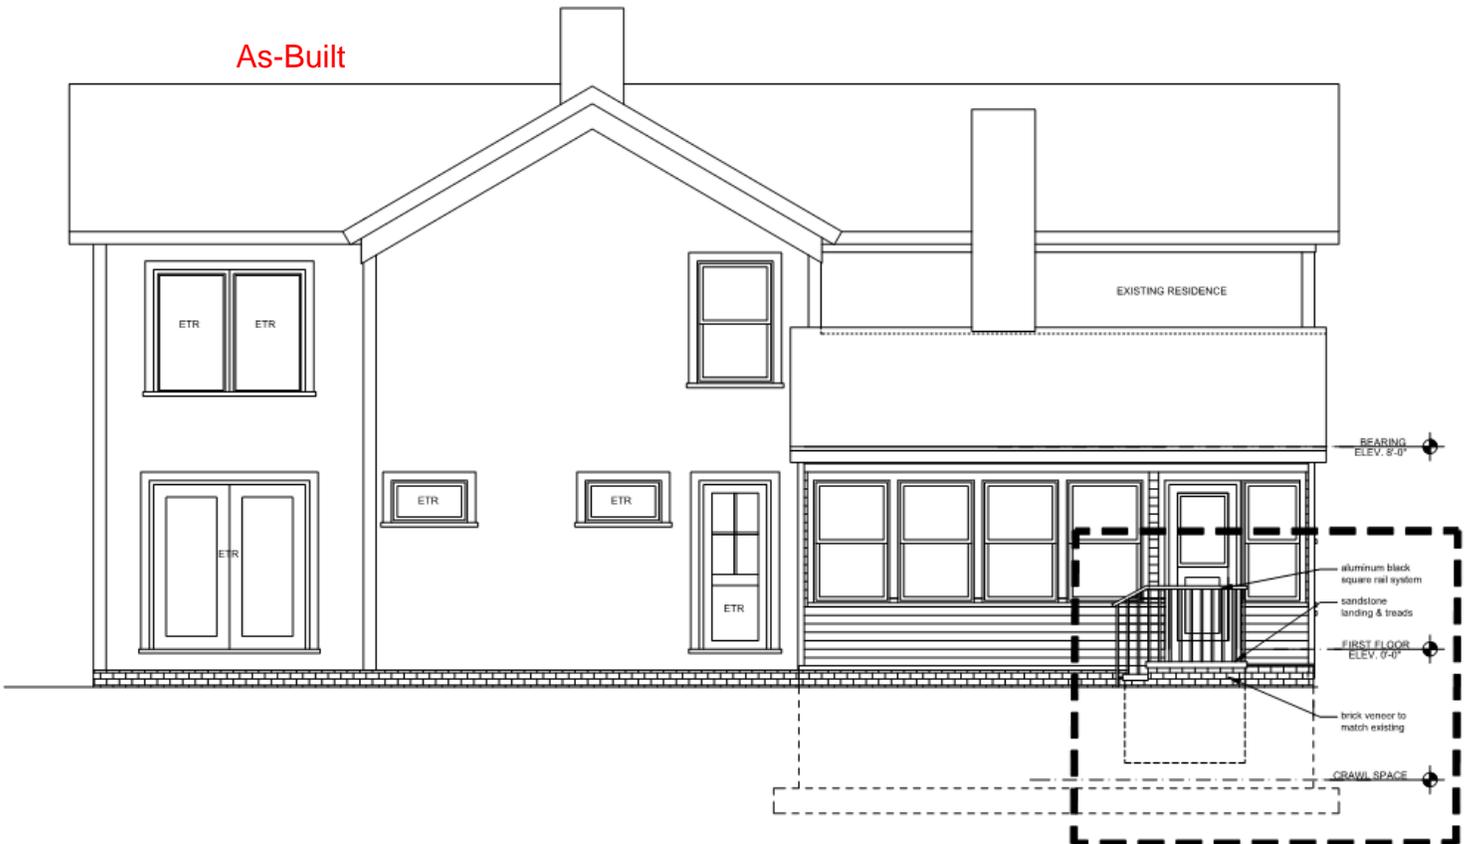


EAST ELEVATION

Previously Approved: 8/8/2018

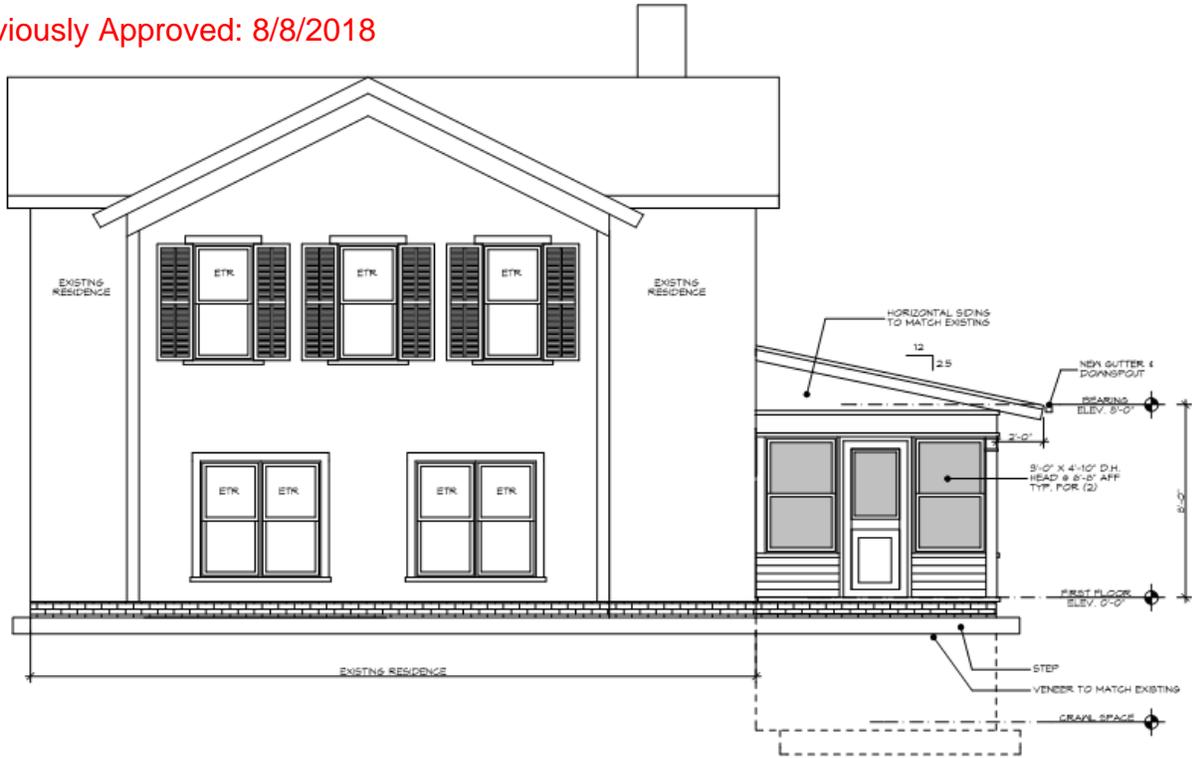

3 EAST ELEVATION

As-Built

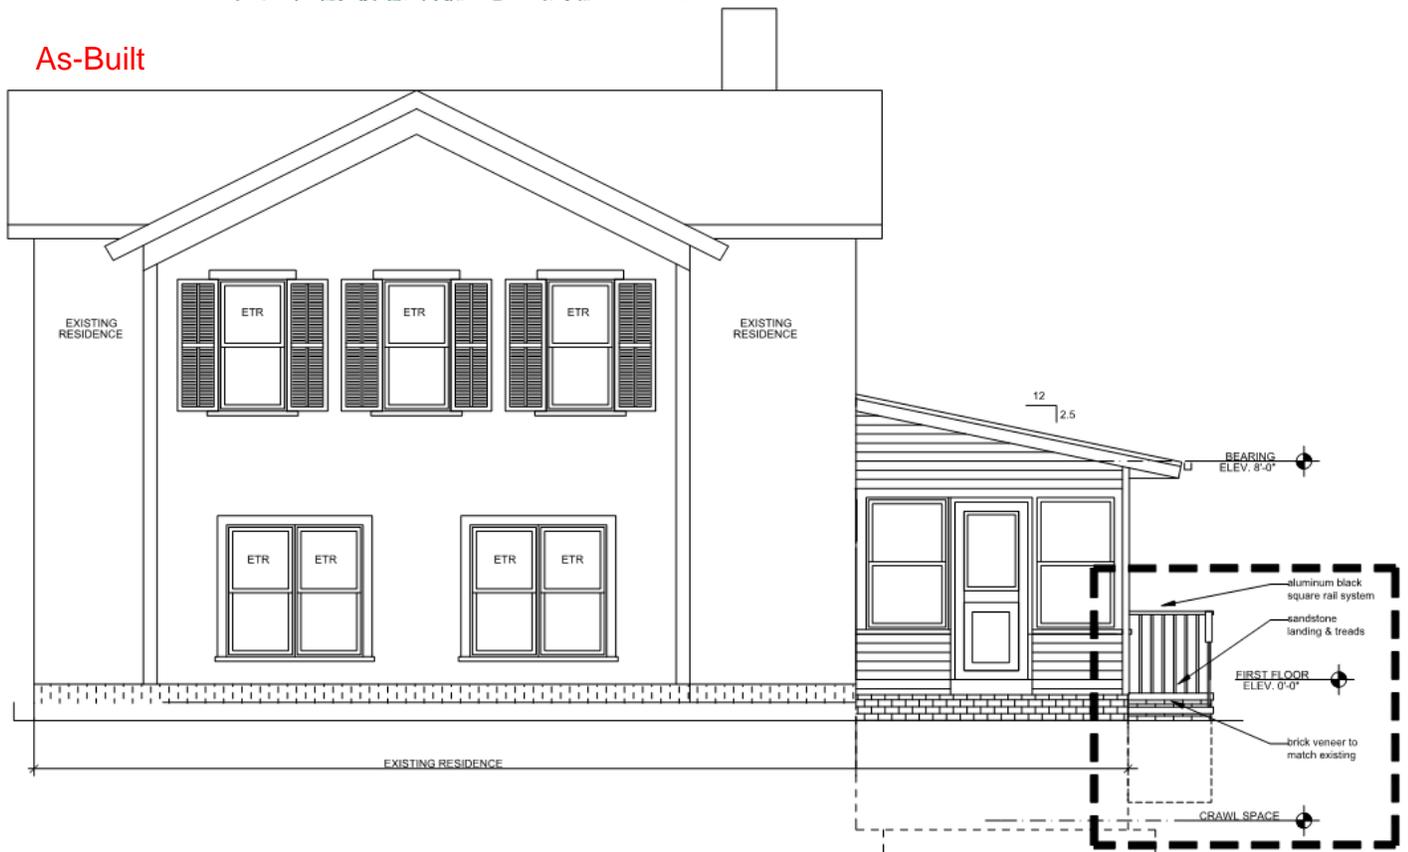



145













